
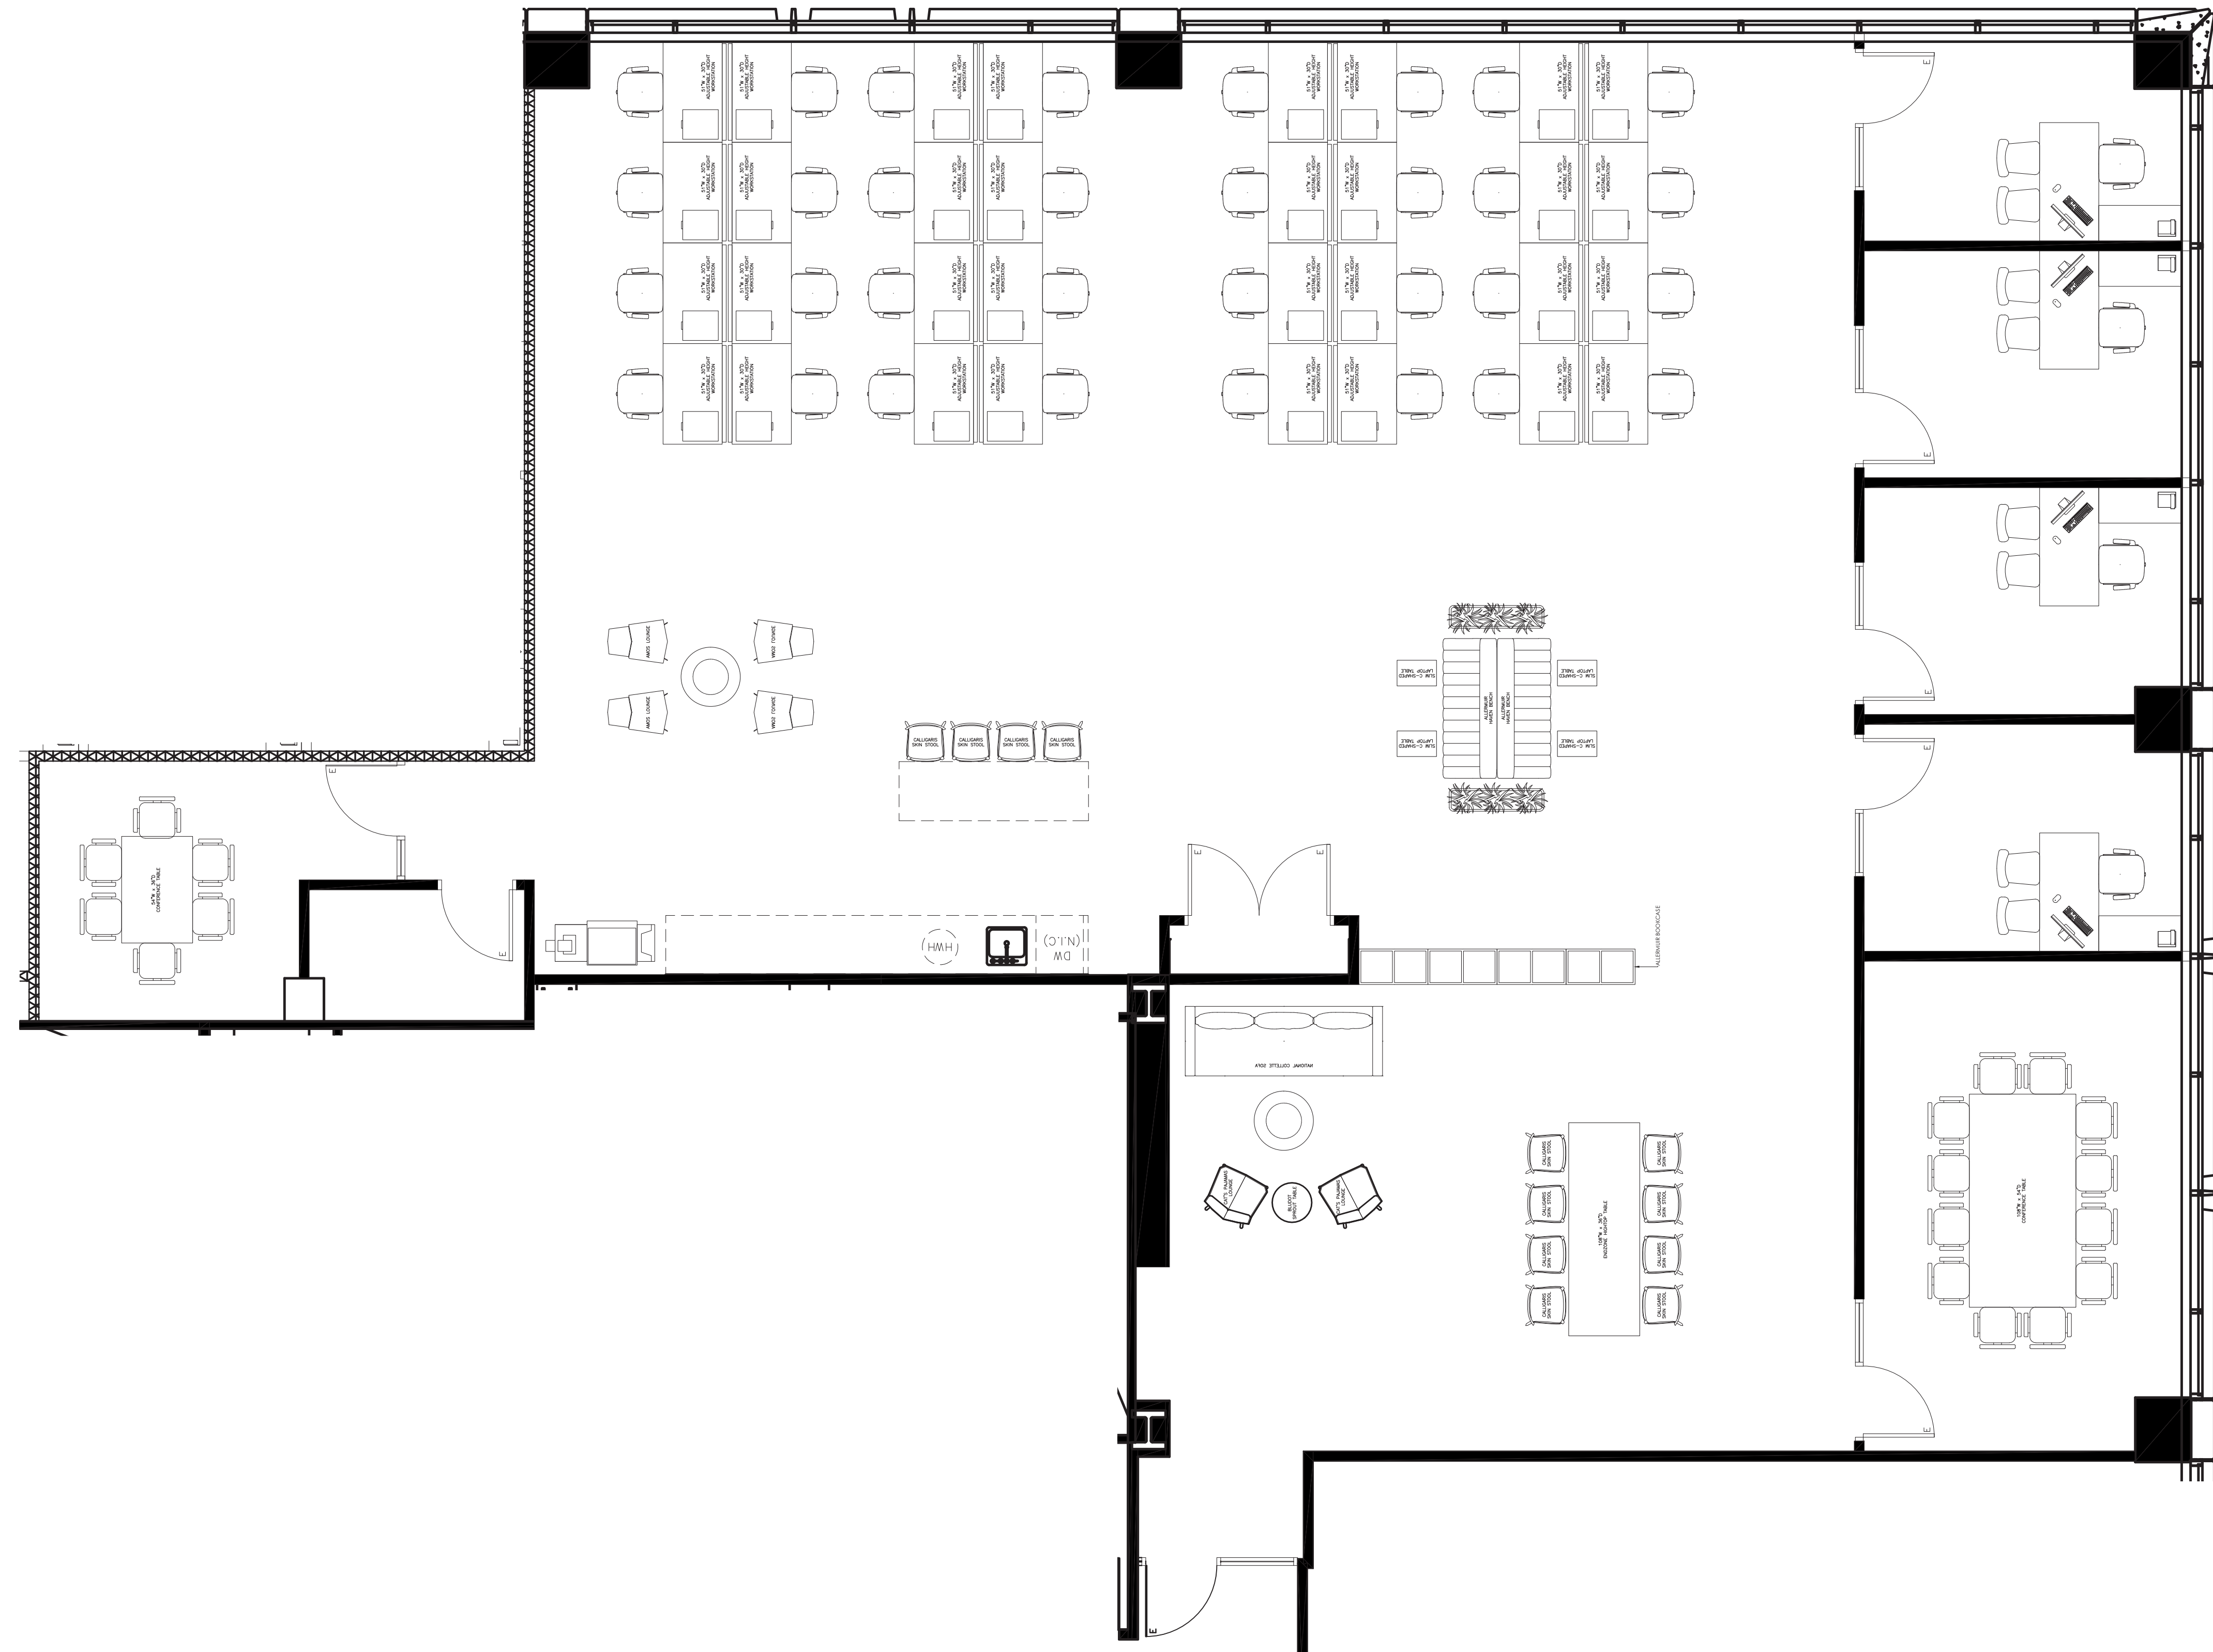


## AS-BUILT CONFIGURATION

OFFICES.....	4
RECEPTION.....	1
CONFERENCE ROOMS.....	2
KITCHEN.....	1
OPEN WORK AREA.....	+/- 32

*Not to scale, furniture and appliances not included*

## KEY PLAN

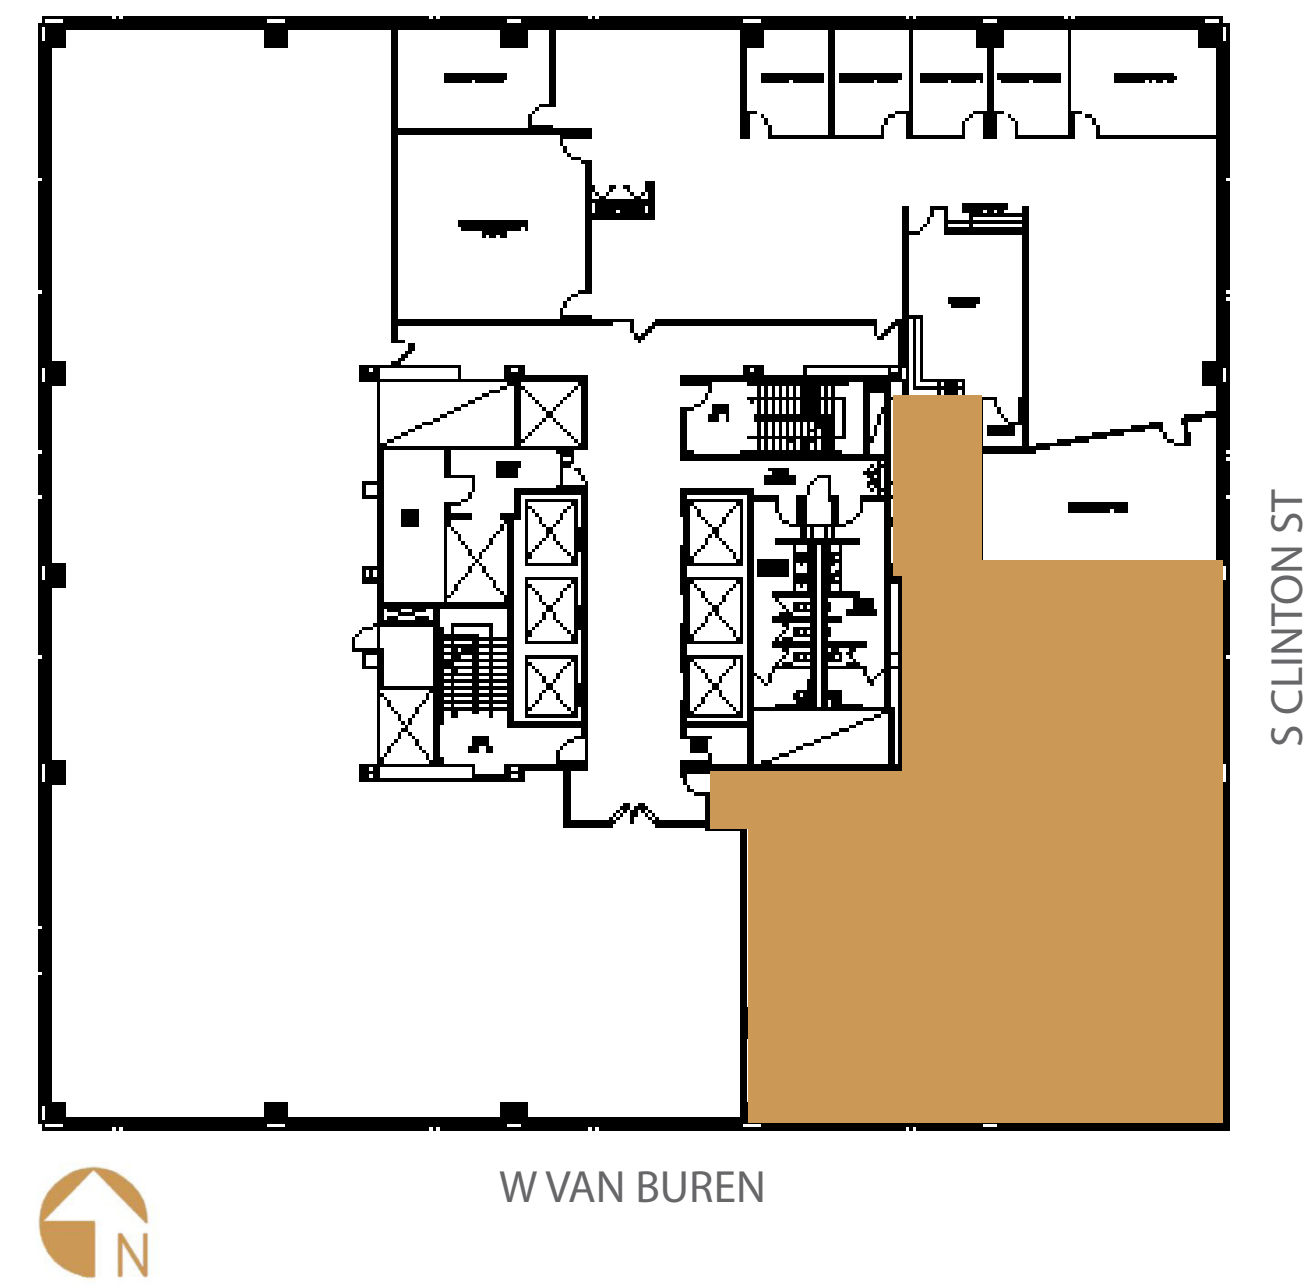

For leasing information please contact:  
 Mark J. Gunderson  
 312.448.8645  
 mark.gunderson@streamrealty.com

Ben Cleveland  
 312.448.6221  
 ben.cleveland@streamrealty.com