


AS-BUILT CONFIGURATION

OFFICES.....	5
RECEPTION.....	1
CONFERENCE ROOMS.....	2
KITCHEN.....	1
OPEN WORK AREA.....	+/- 34

Not to scale, furniture and appliances not included

KEY PLAN

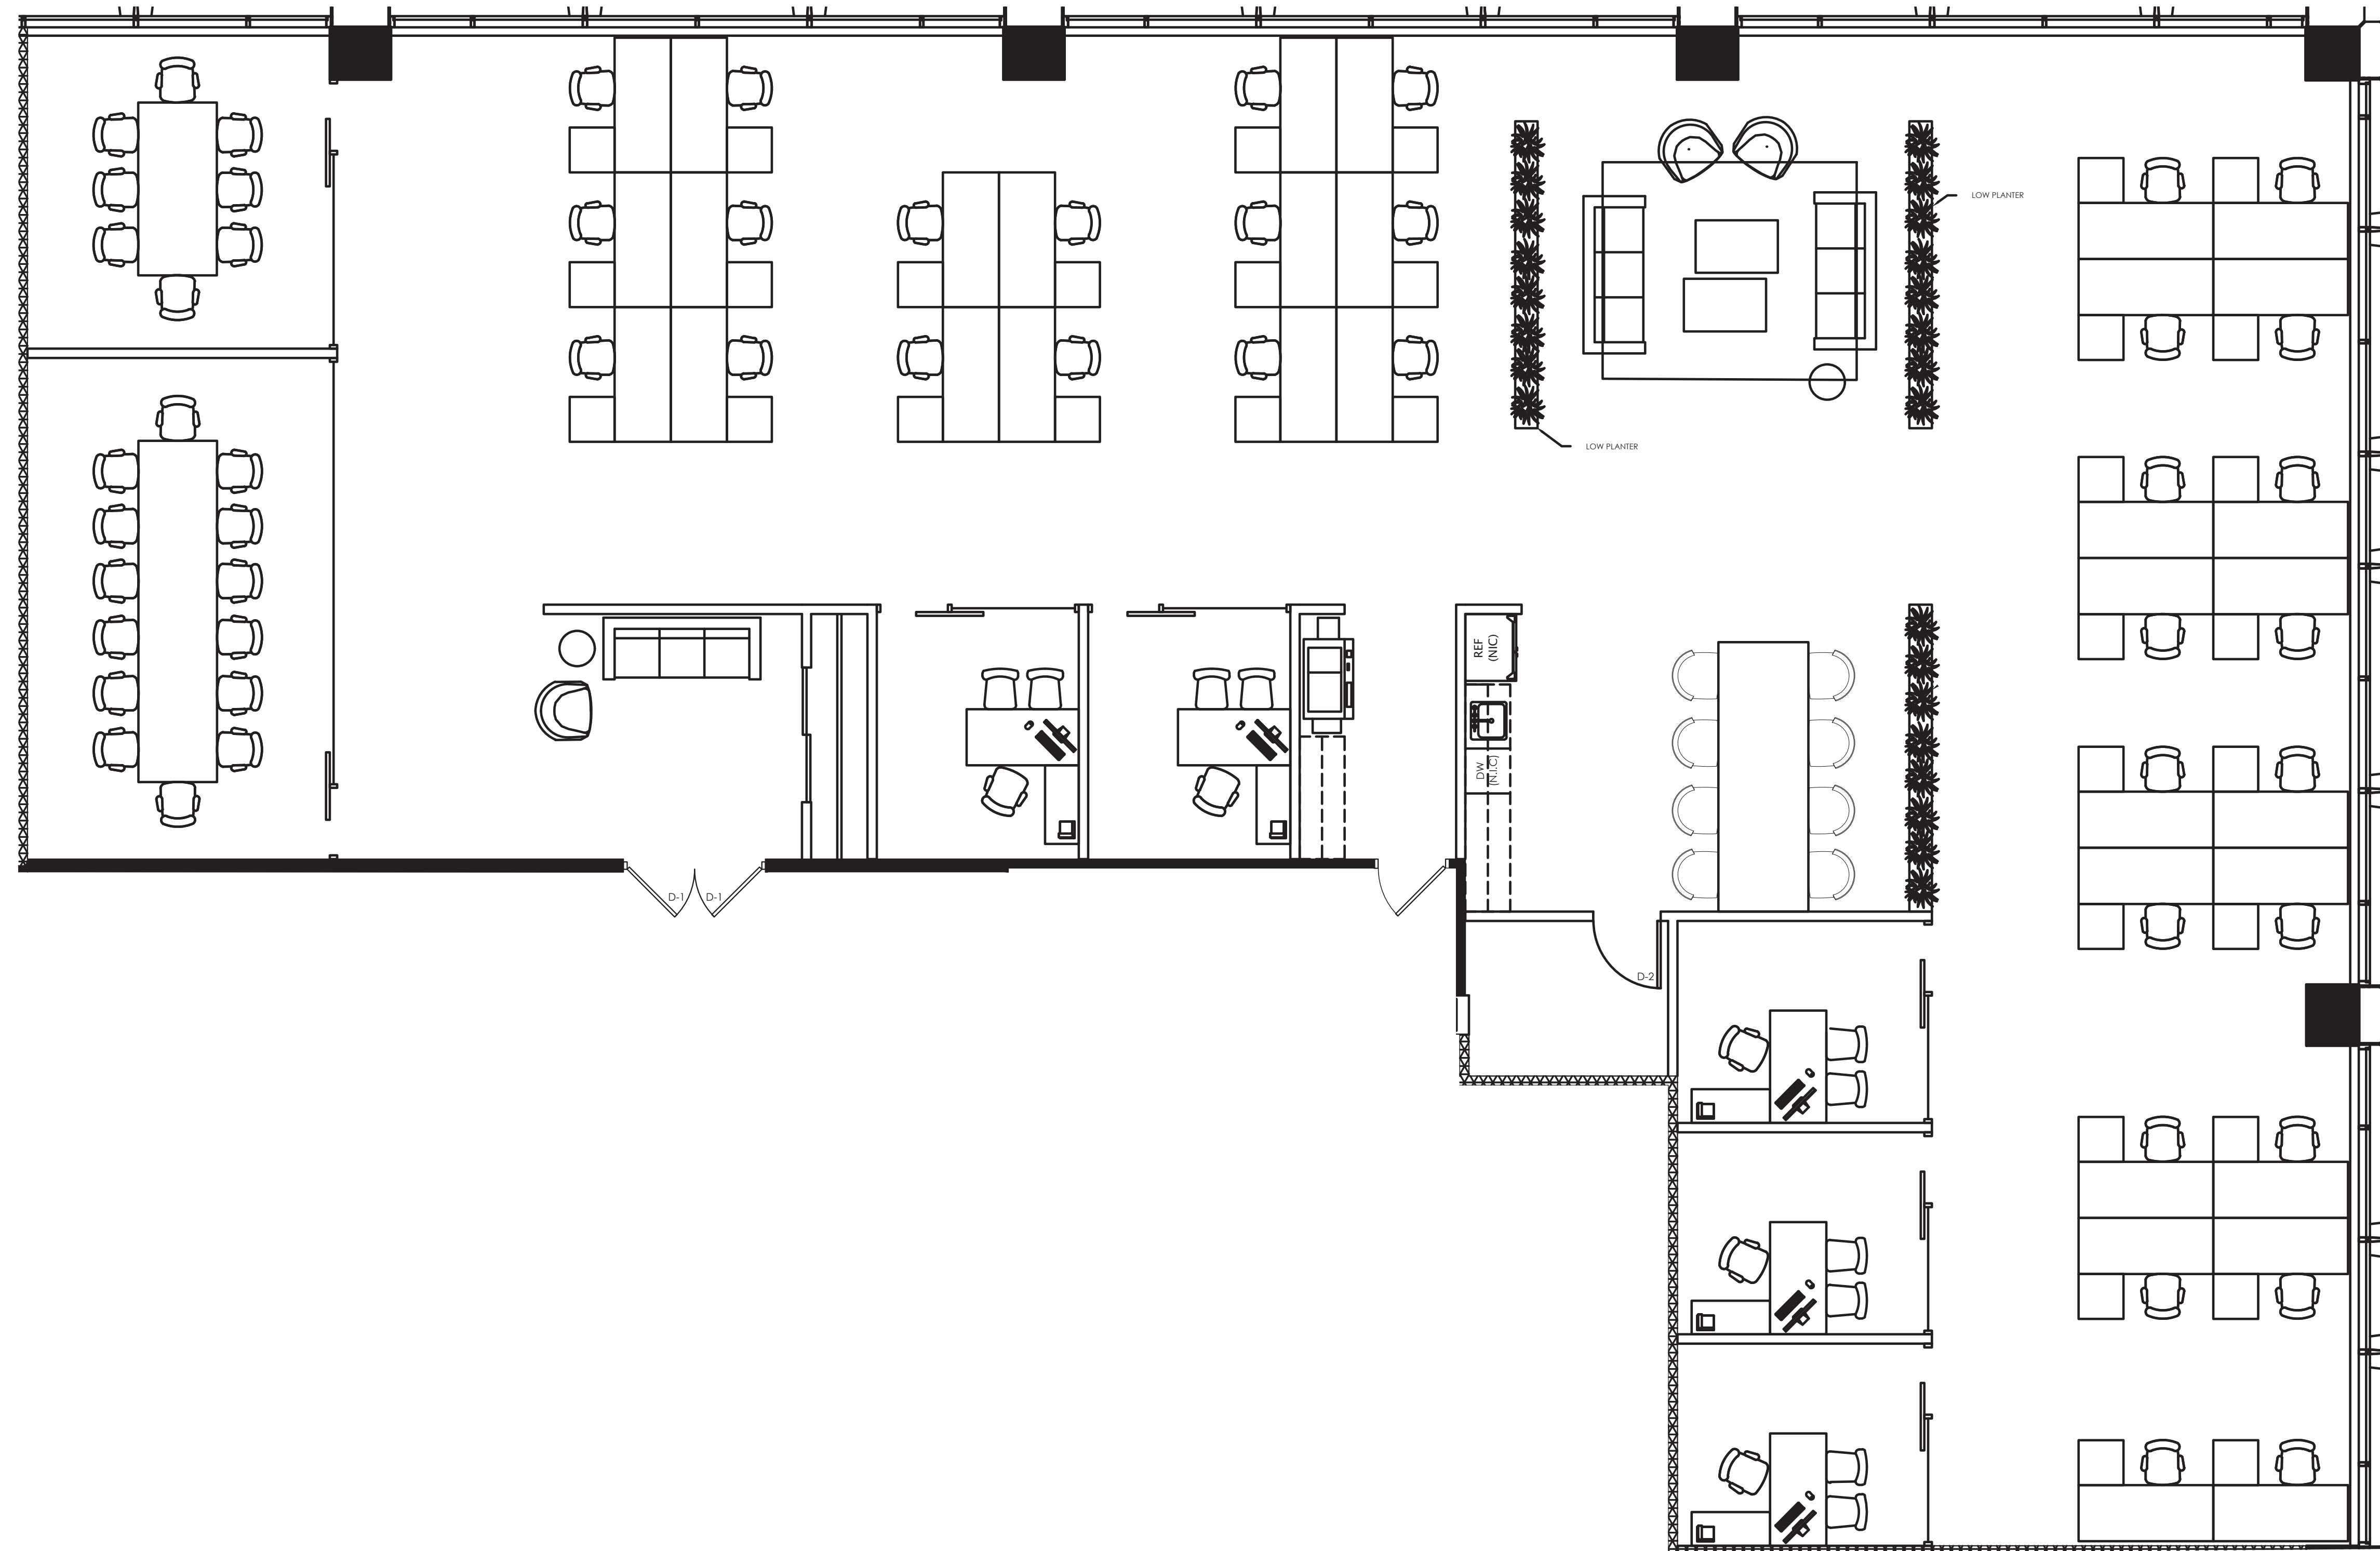

For leasing information please contact:
 Mark J. Gunderson
 312.448.8645
 mark.gunderson@streamrealty.com

Ben Cleveland
 312.448.6221
 ben.cleveland@streamrealty.com