


# SUITE: 1530 | RSF: 3,634 SF

## AS-BUILT CONFIGURATION

OFFICES.....	2
RECEPTION.....	1
CONFERENCE ROOMS.....	1
KITCHEN.....	1
OPEN WORK AREA.....	+/-24

*Not to scale, furniture and appliances not included*

## KEY PLAN

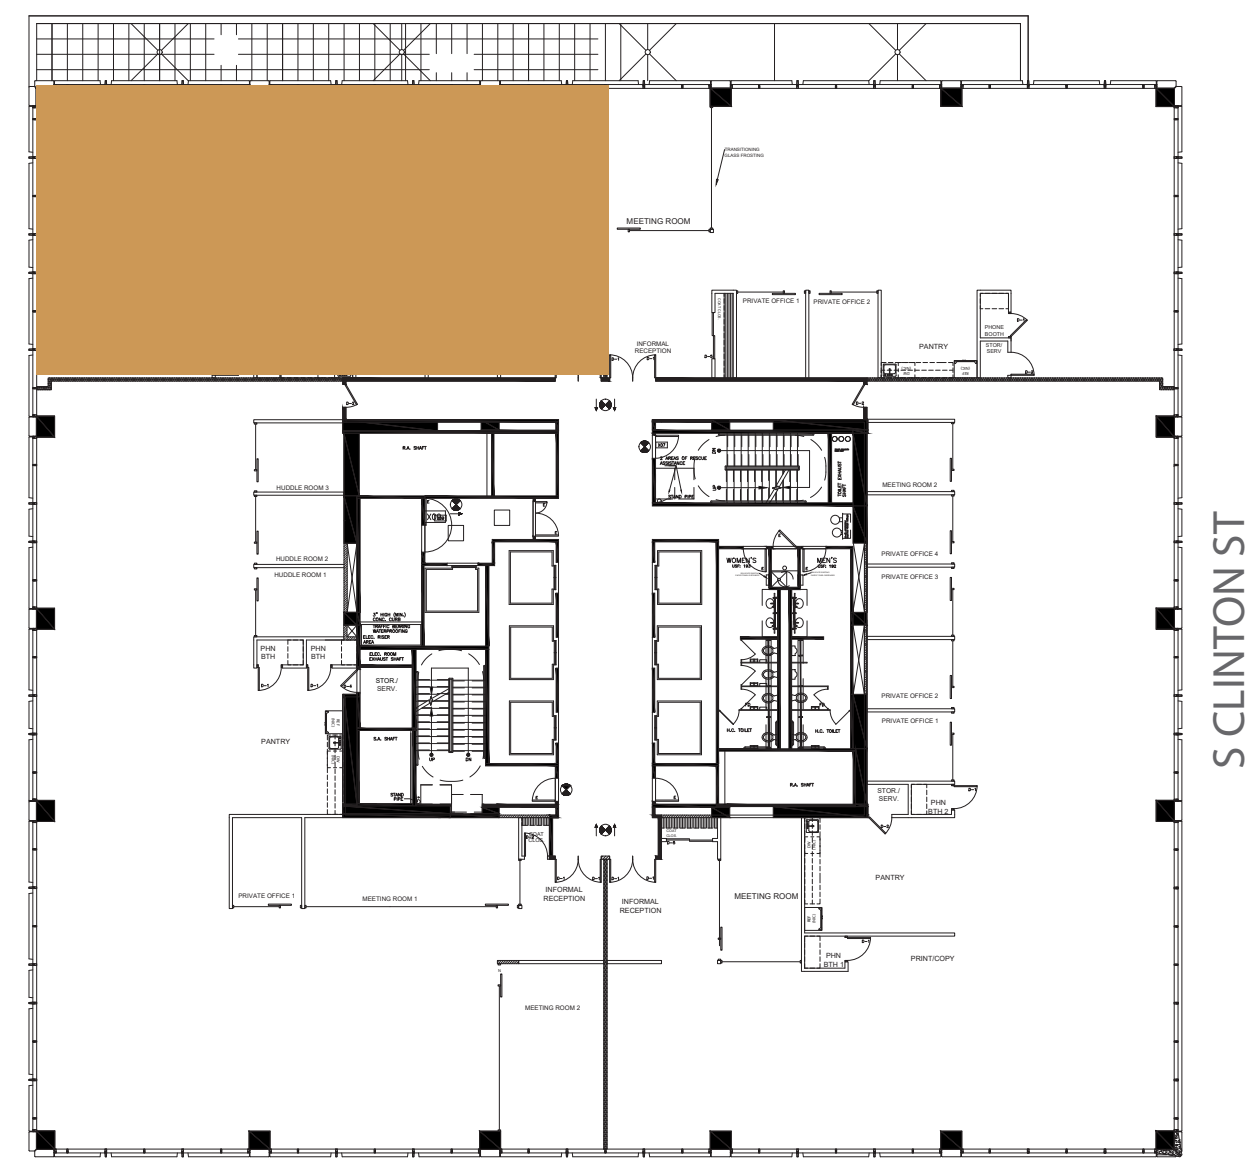

W VAN BUREN

S CLINTON ST

