

AS-BUILT CONFIGURATION

- OFFICES..... 5
- RECEPTION..... 1
- CONFERENCE ROOMS..... 4
- KITCHEN..... 1

SCENARIO A FURNITURE


(63) 5'-X2'-6" BENCHING
WITH (4) BREAKOUT AREAS

SCENARIO B FURNITURE

(34) 6'-X6' CUBICLES
WITH (4) BREAKOUT AREAS


KEY PLAN

Not to scale, furniture and appliances not included

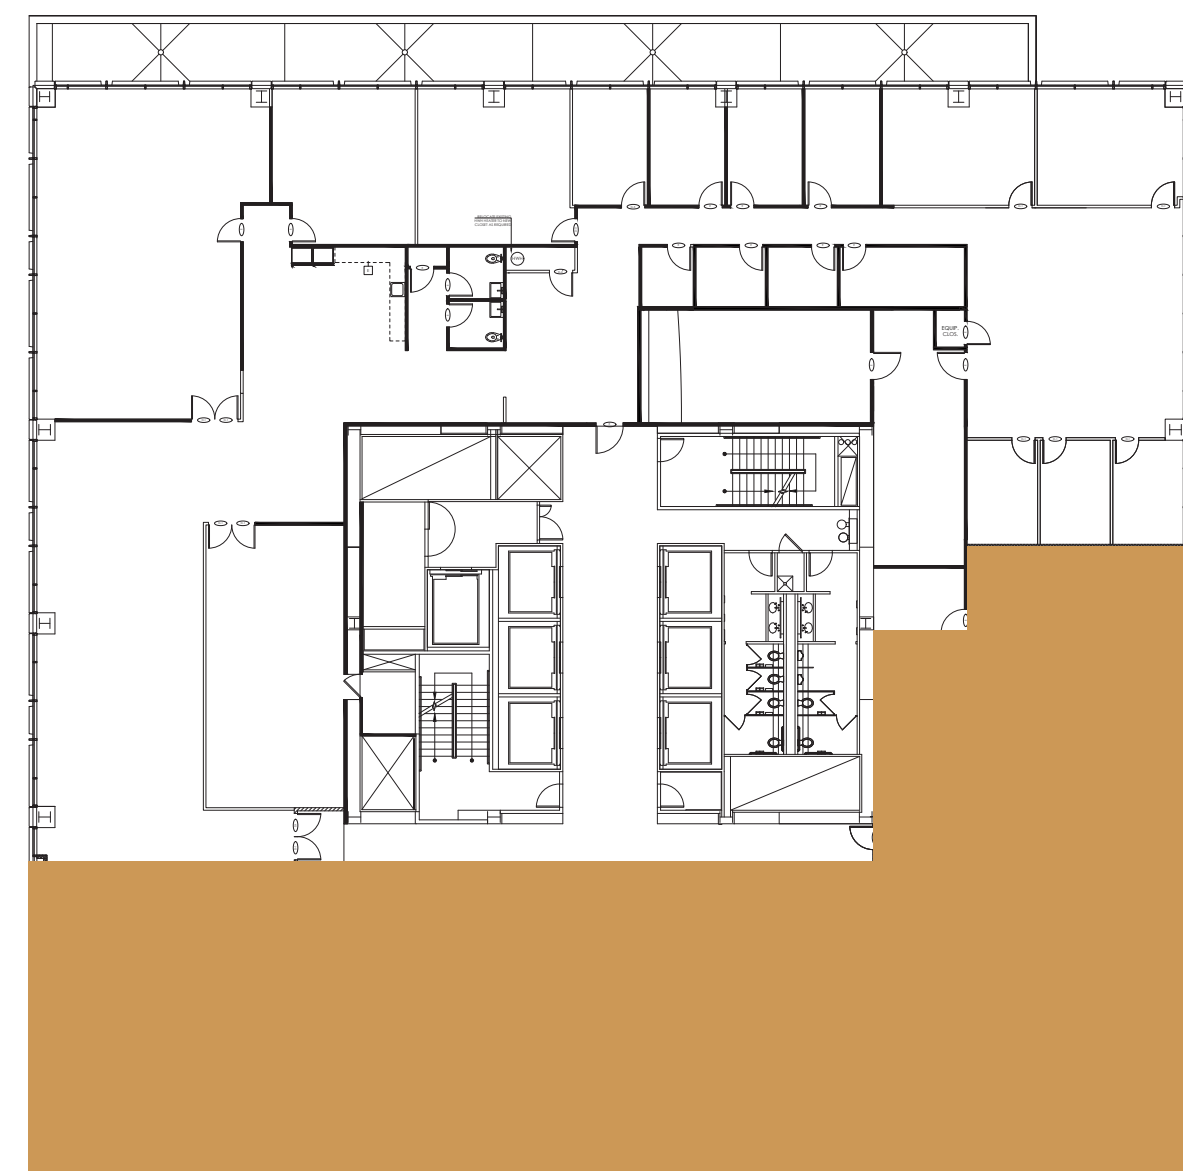


CLINTON ST.

W VAN BUREN ST.

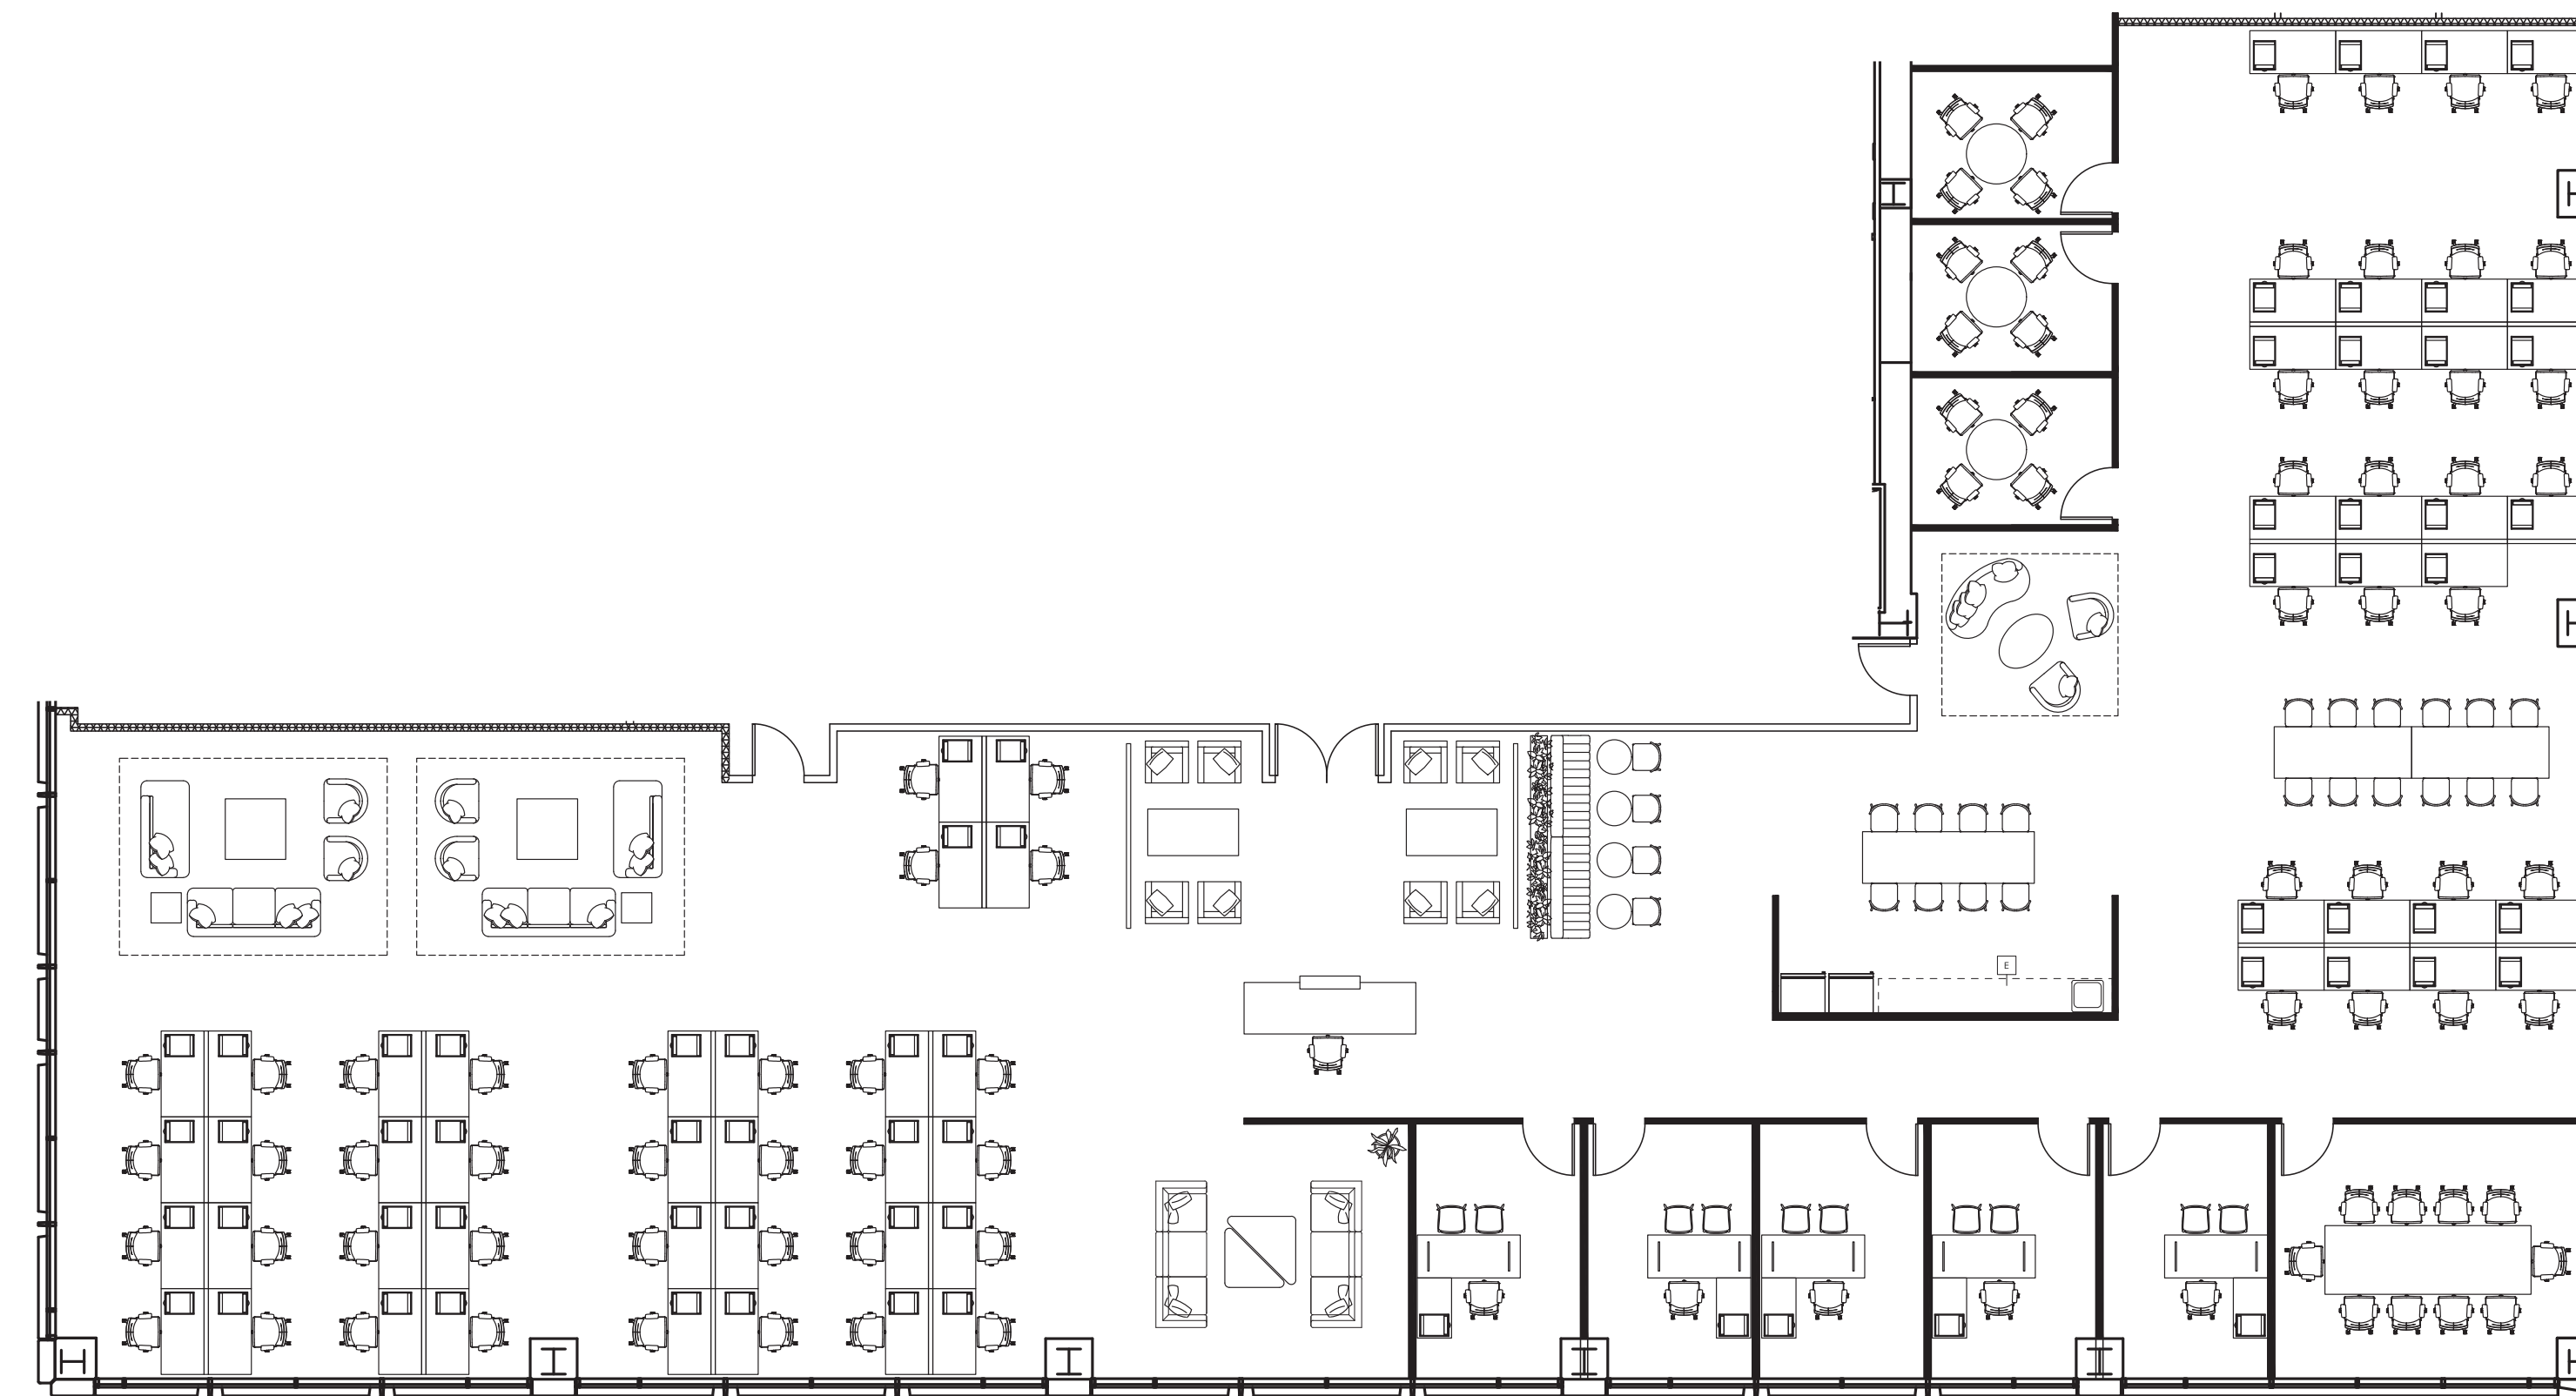

SCENARIO A

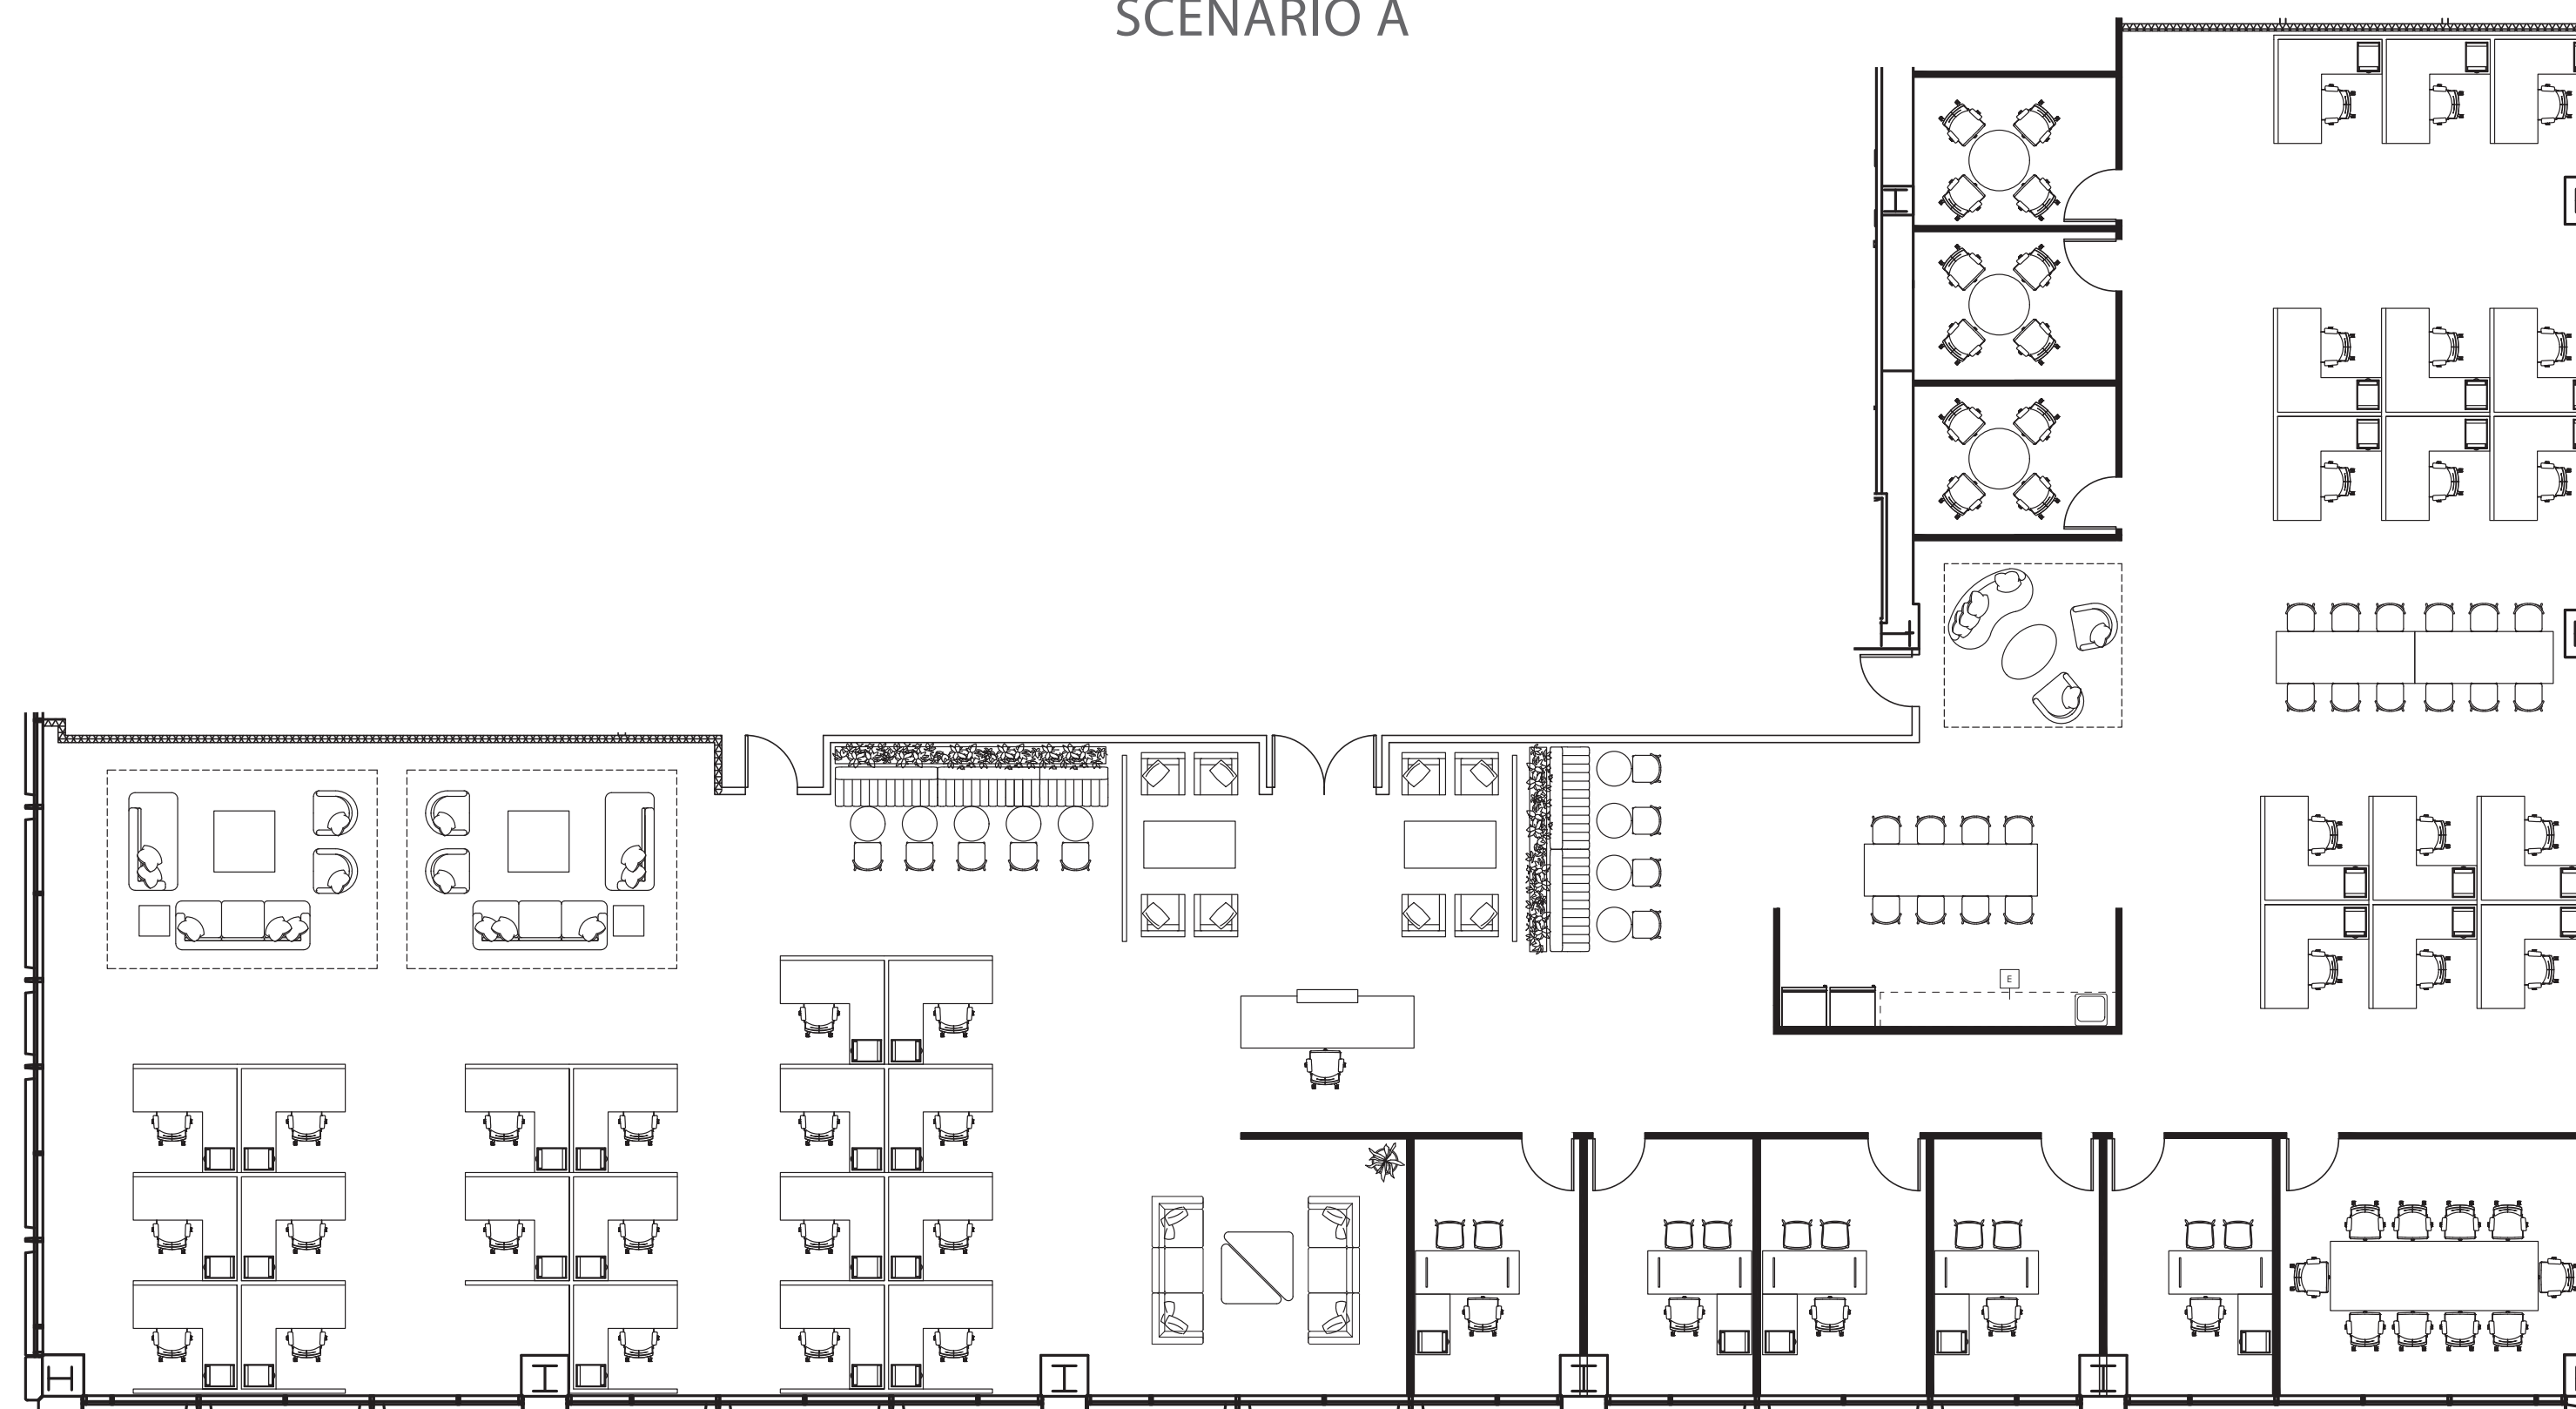

SCENARIO B