
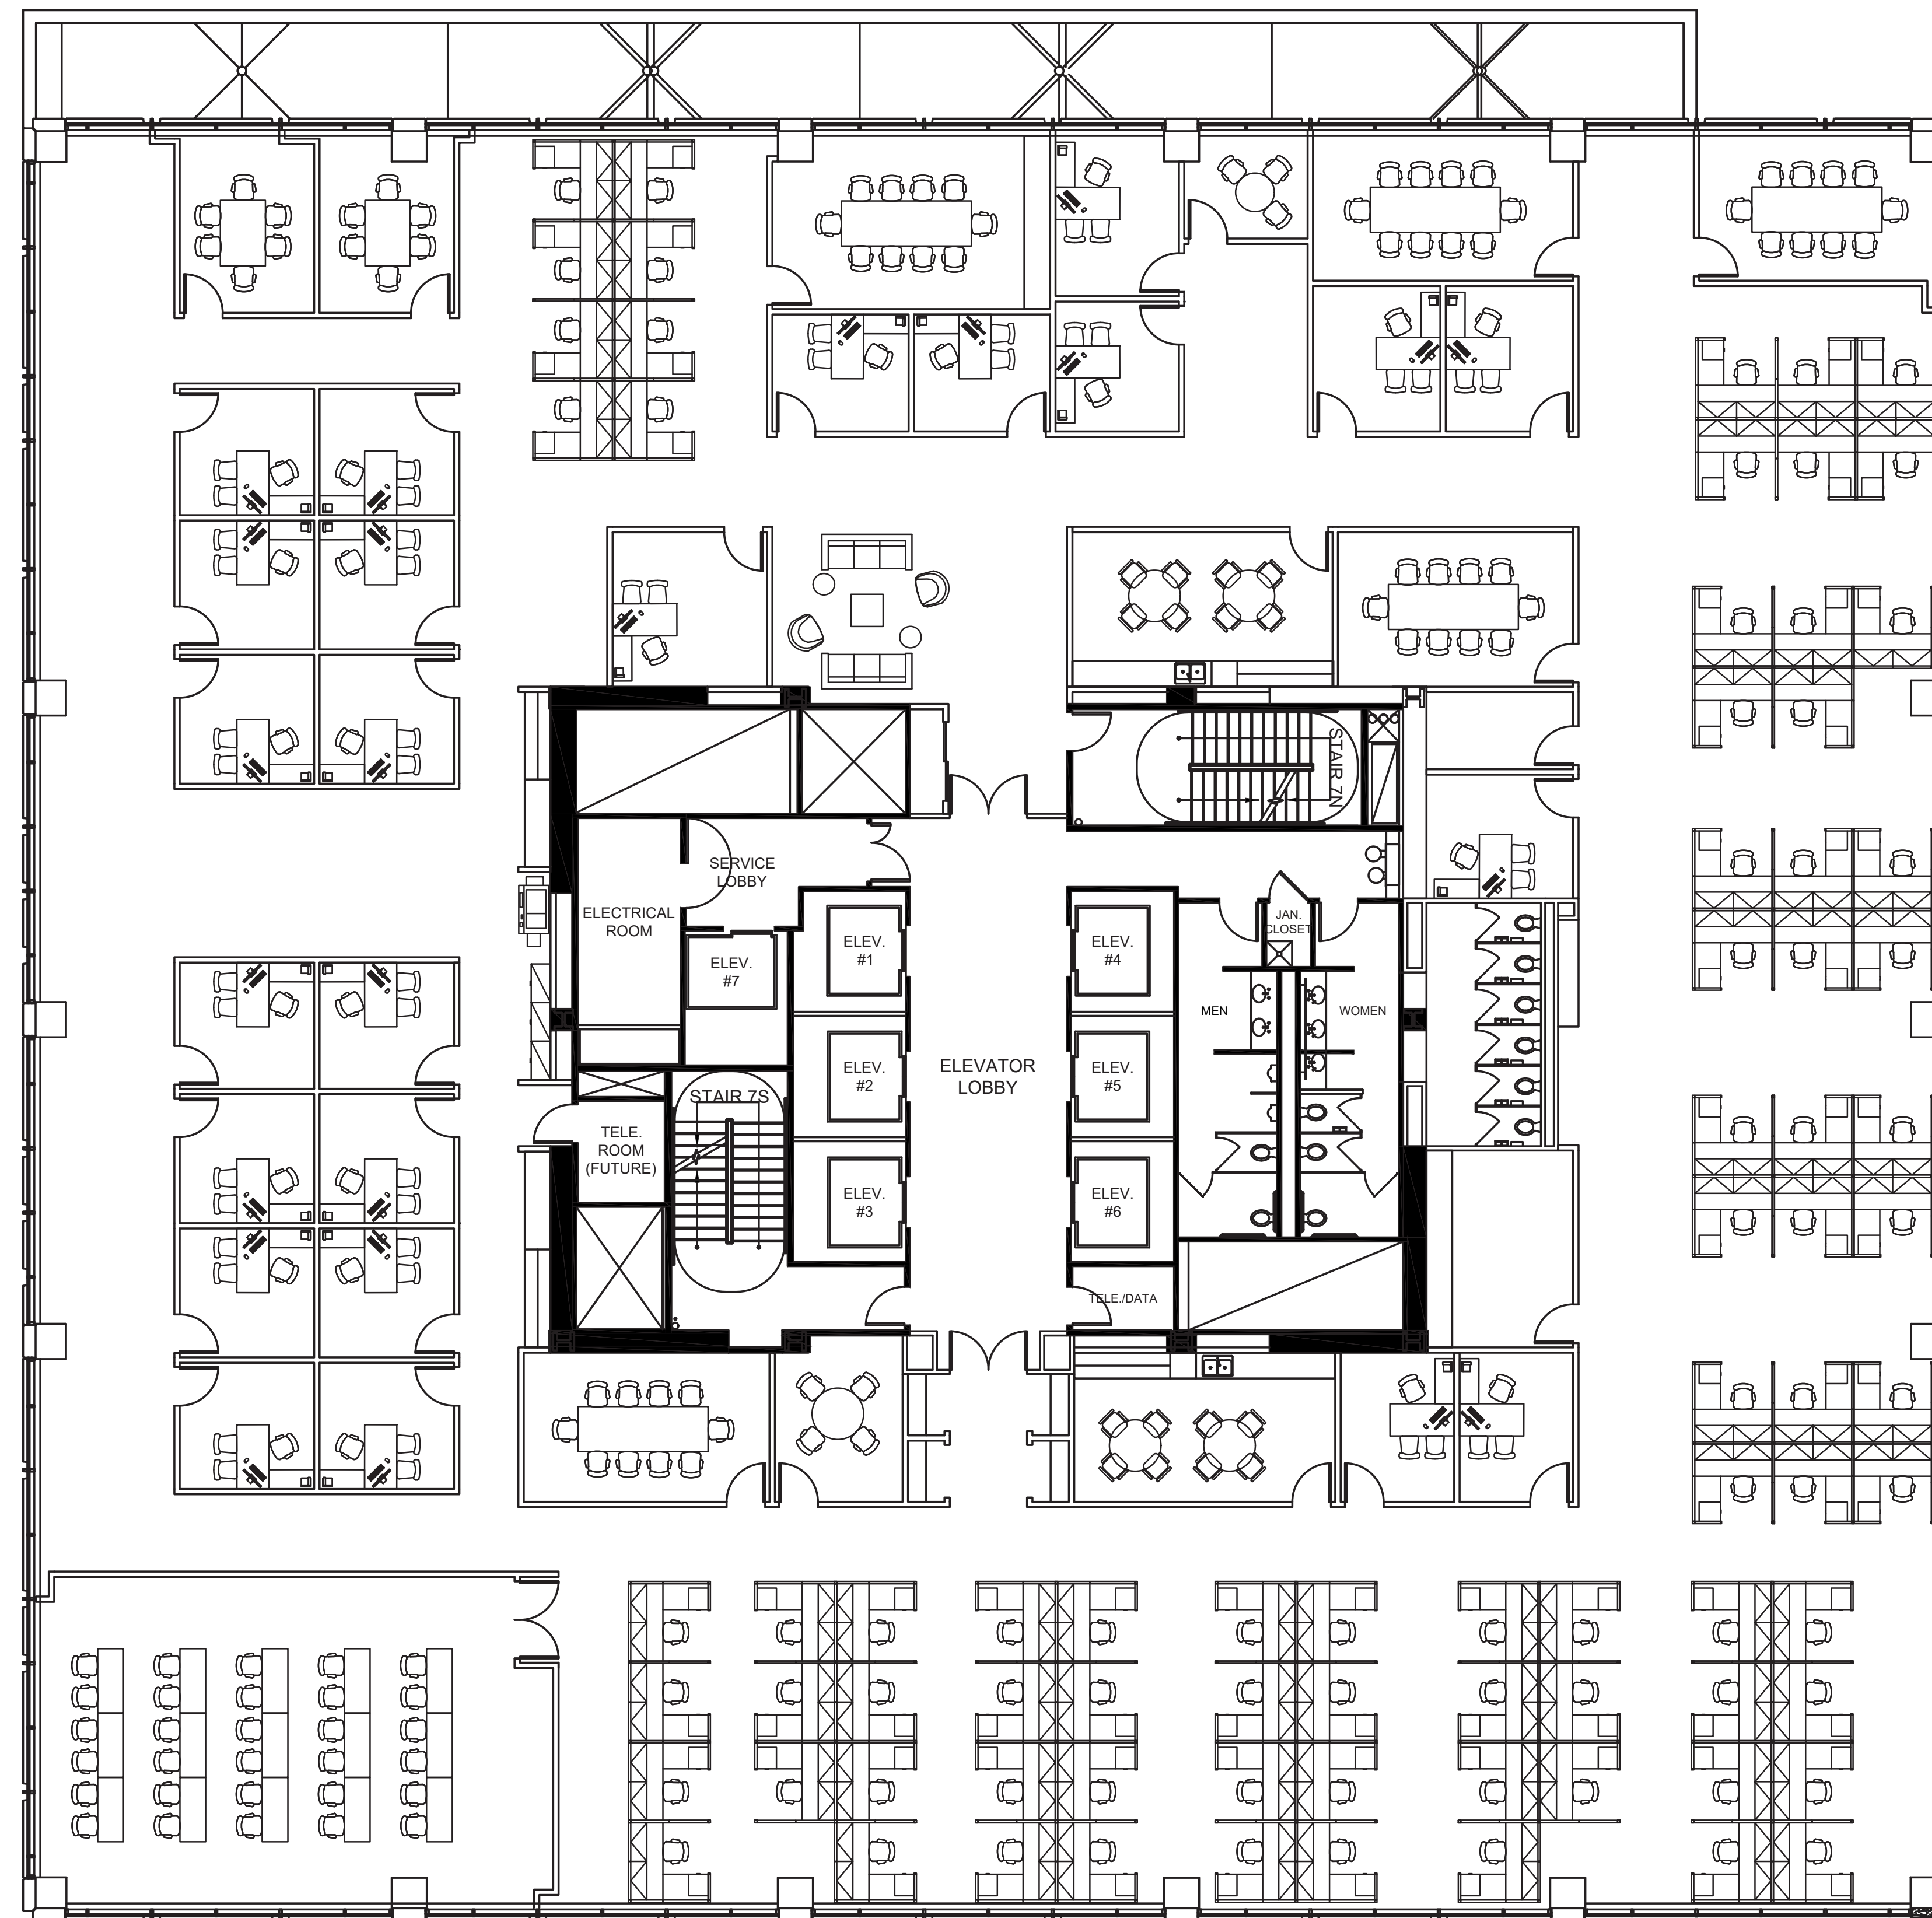


AS-BUILT CONFIGURATION

OFFICES.....	24
RECEPTION.....	1
CONFERENCE ROOMS.....	8
KITCHEN.....	2
OPEN WORK AREA.....	+/- 79

Not to scale, furniture and appliances not included

KEY PLAN

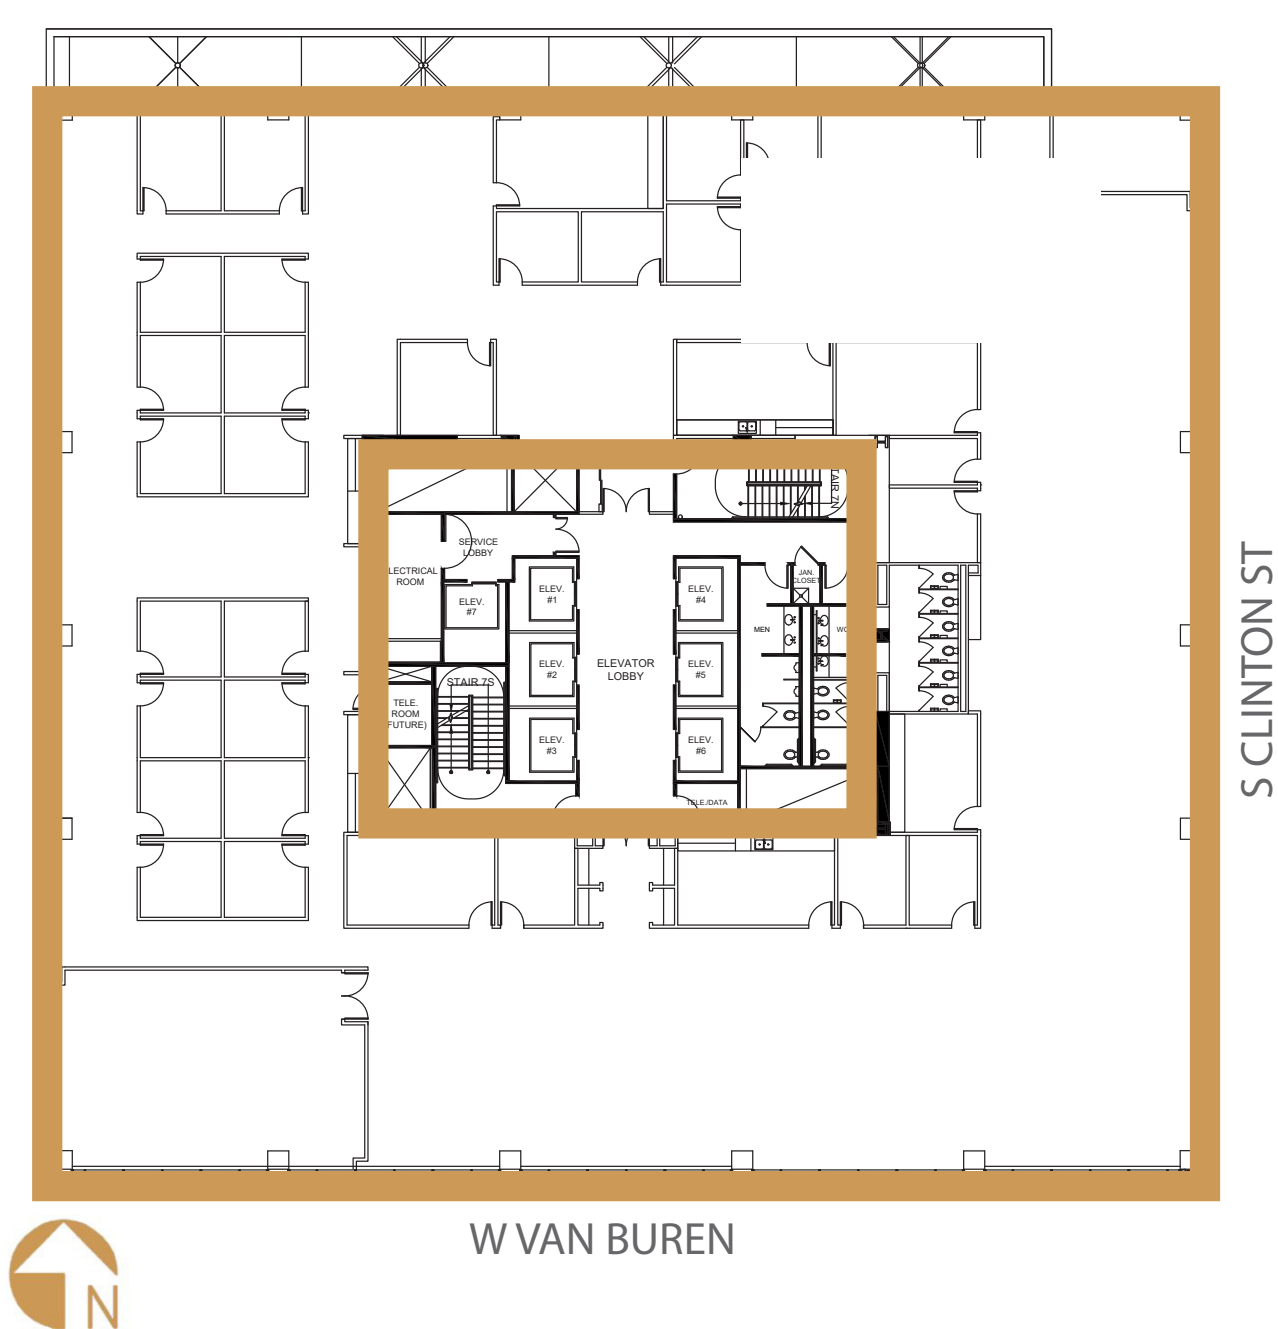

For leasing information please contact:
 Mark J. Gunderson
 312.448.8645
 mark.gunderson@streamrealty.com

Ben Cleveland
 312.448.6221
 ben.cleveland@streamrealty.com